



NOTES
 -ALL SEWER RETICULATION PIPES ARE Ø160 PE-100 SDR21 U.N.O.
 -ALL SEWER HOUSE CONNECTION PIPES ARE Ø110 PE-100 SDR21 U.N.O.

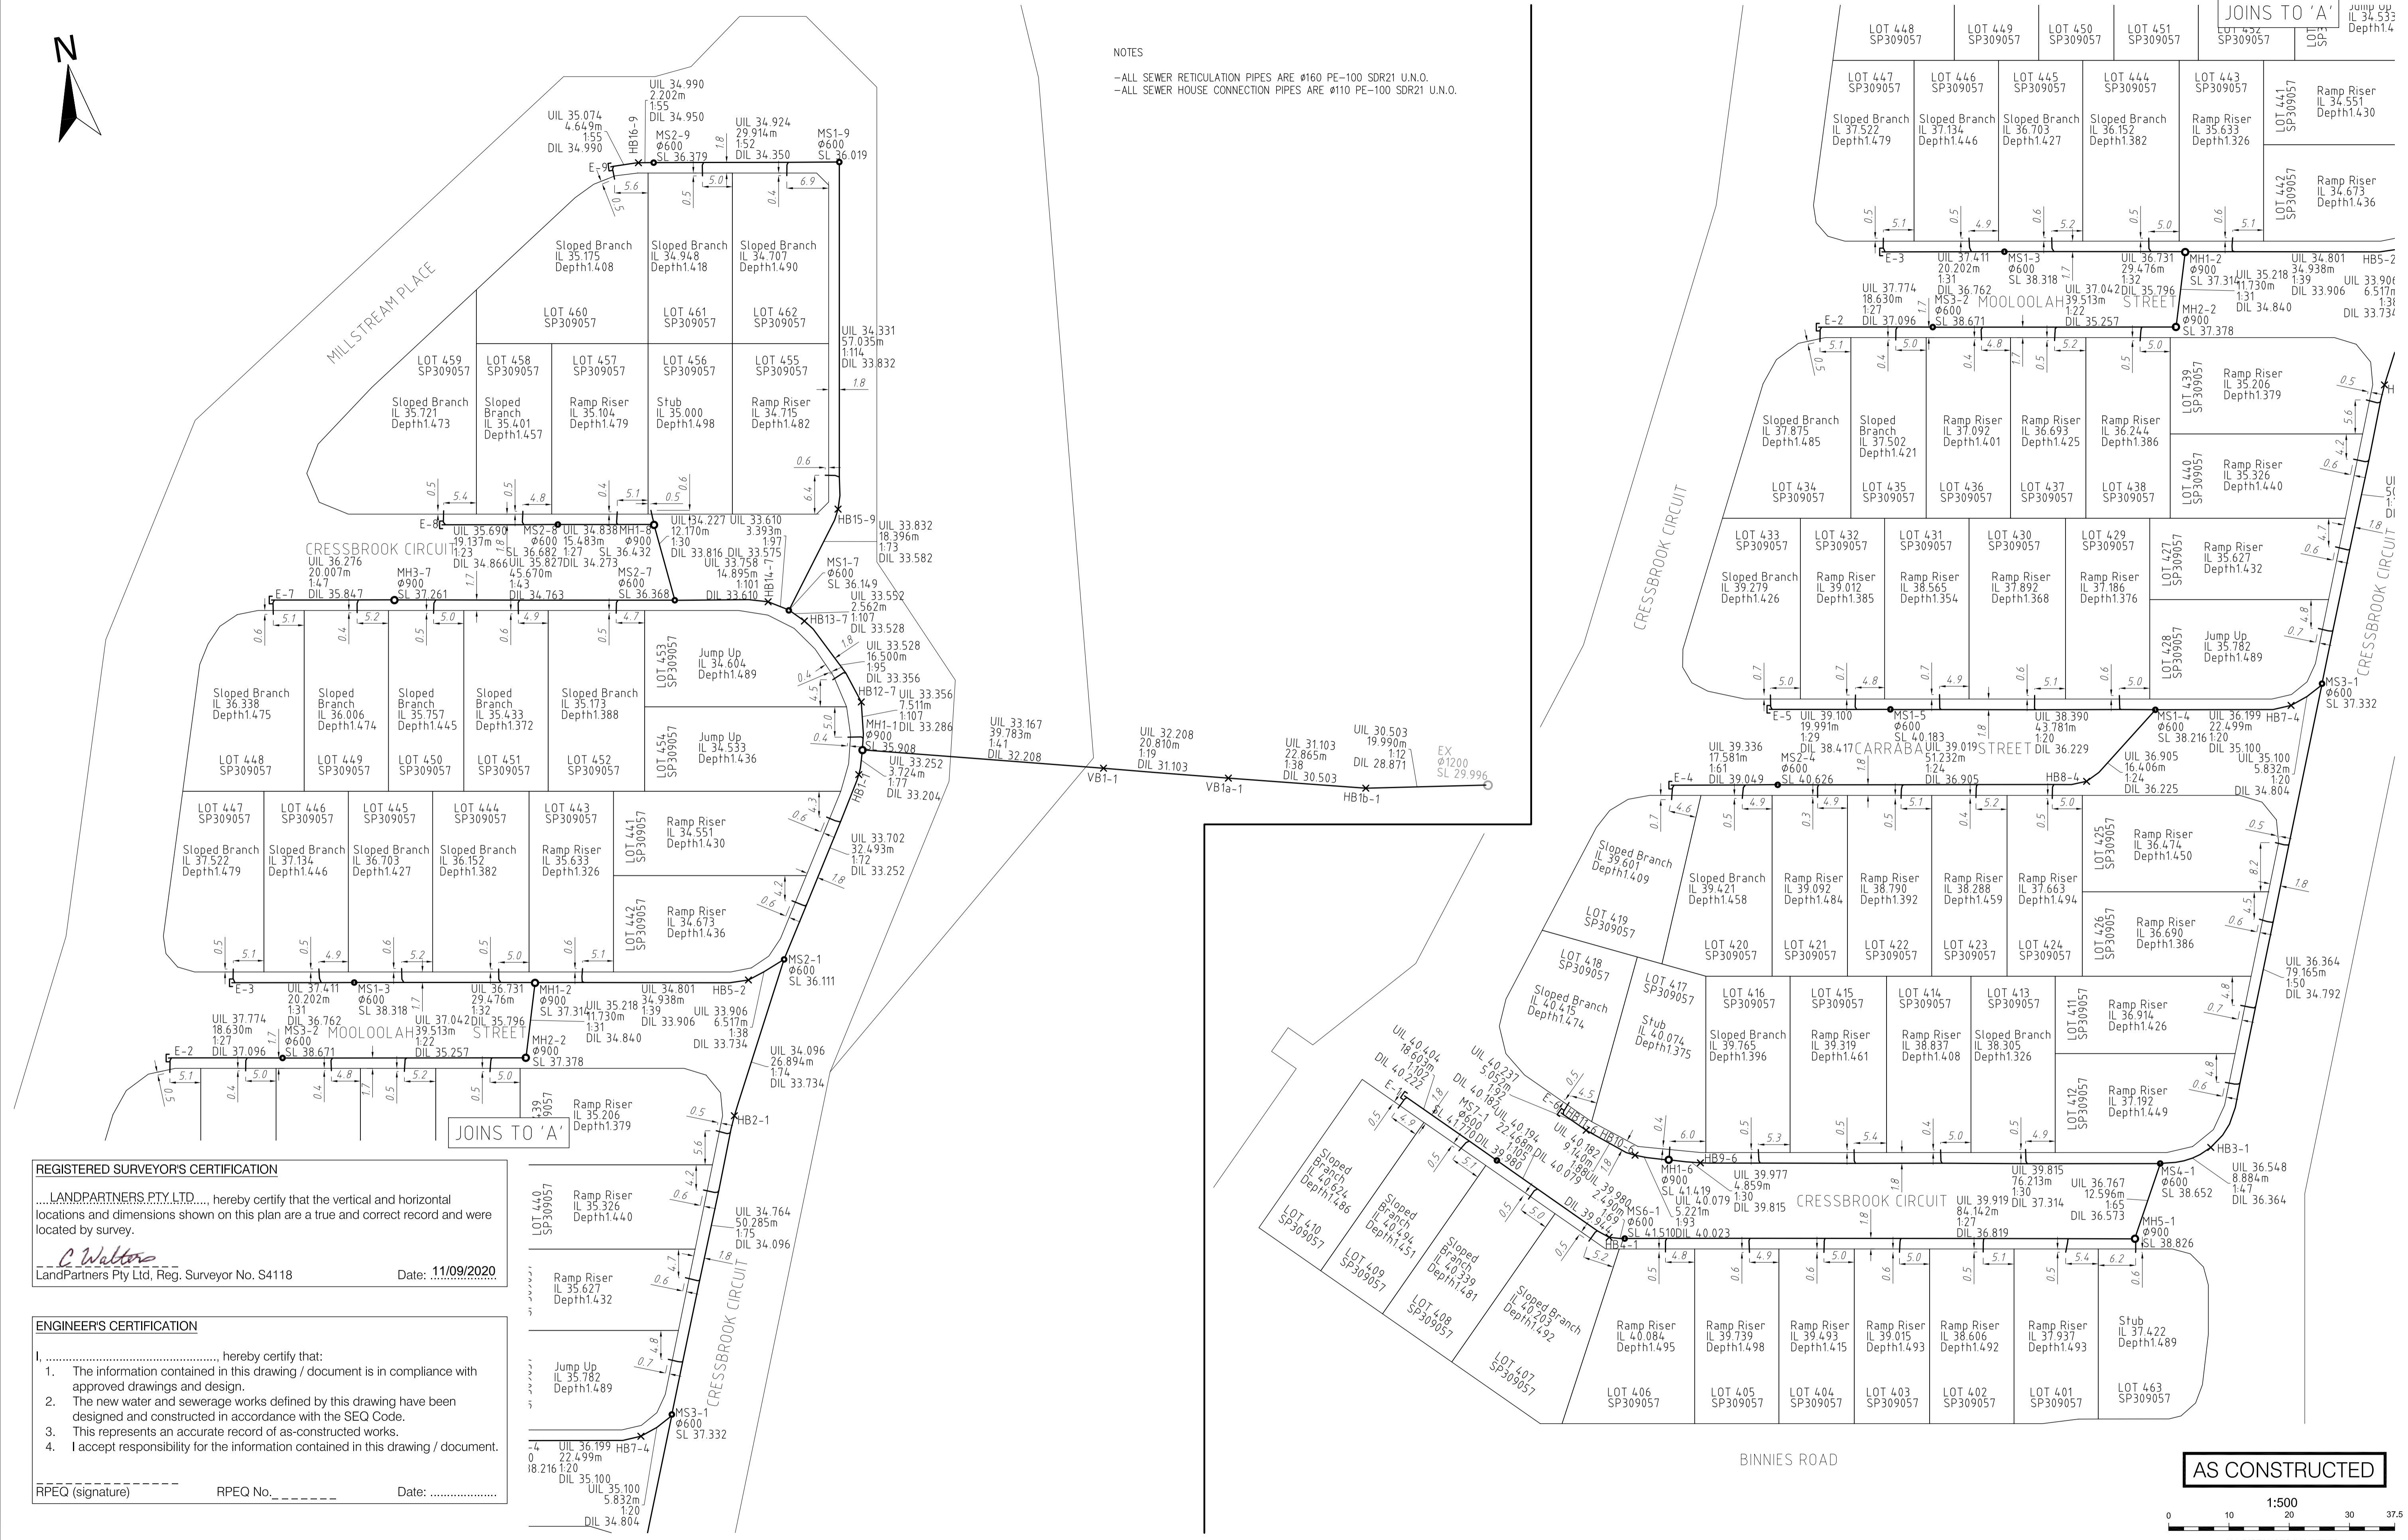

REGISTERED SURVEYOR'S CERTIFICATION
 I, LandPartners Pty Ltd, hereby certify that the vertical and horizontal locations and dimensions shown on this plan are a true and correct record and were located by survey.
 Date: **11/09/2020**
 LandPartners Pty Ltd, Reg. Surveyor No. S4118

ENGINEER'S CERTIFICATION
 I, _____, hereby certify that:
 1. The information contained in this drawing / document is in compliance with approved drawings and design.
 2. The new water and sewerage works defined by this drawing have been designed and constructed in accordance with the SEQ Code.
 3. This represents an accurate record of as-constructed works.
 4. I accept responsibility for the information contained in this drawing / document.
 RPEQ (signature) RPEQ No. _____ Date: _____

AS CONSTRUCTED

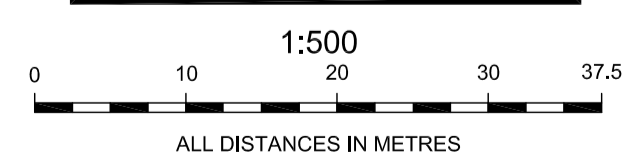

A1	1	11/09/2020	INITIAL ISSUE	BJB	RA	RA
	REVISIONS			DRAWN	CHECKED	PASSED
DRAWN		CHECKED		PASSED		INITIALS
DATE		DATE		DATE		DATE

DRAWN: BJB 11/09/2020
 CHECKED: RA 11/09/2020
 PASSED: RA 11/09/2020

1 LAKEVIEW DRIVE, DEEBING HEIGHTS
 AS CONSTRUCTED SEWER
 19-PNT-43549

Queensland Urban Utilities
 SCALE: 1:500
 SHEET 1 OF 1 SHEETS
 DRAWING NO. BRSS5365-030-112-1