



NOTES
 -ALL FIRE HYDRANTS ARE Ø100 SPRING U.N.O.
 -ALL WATER SERVICE PIPE CONDUITS ARE Ø100 PVC PN20 U.N.O.
 -ALL DICTL PIPES ARE PN35
 -ALL WATER MAINS PIPES ARE PN16 U.N.O.

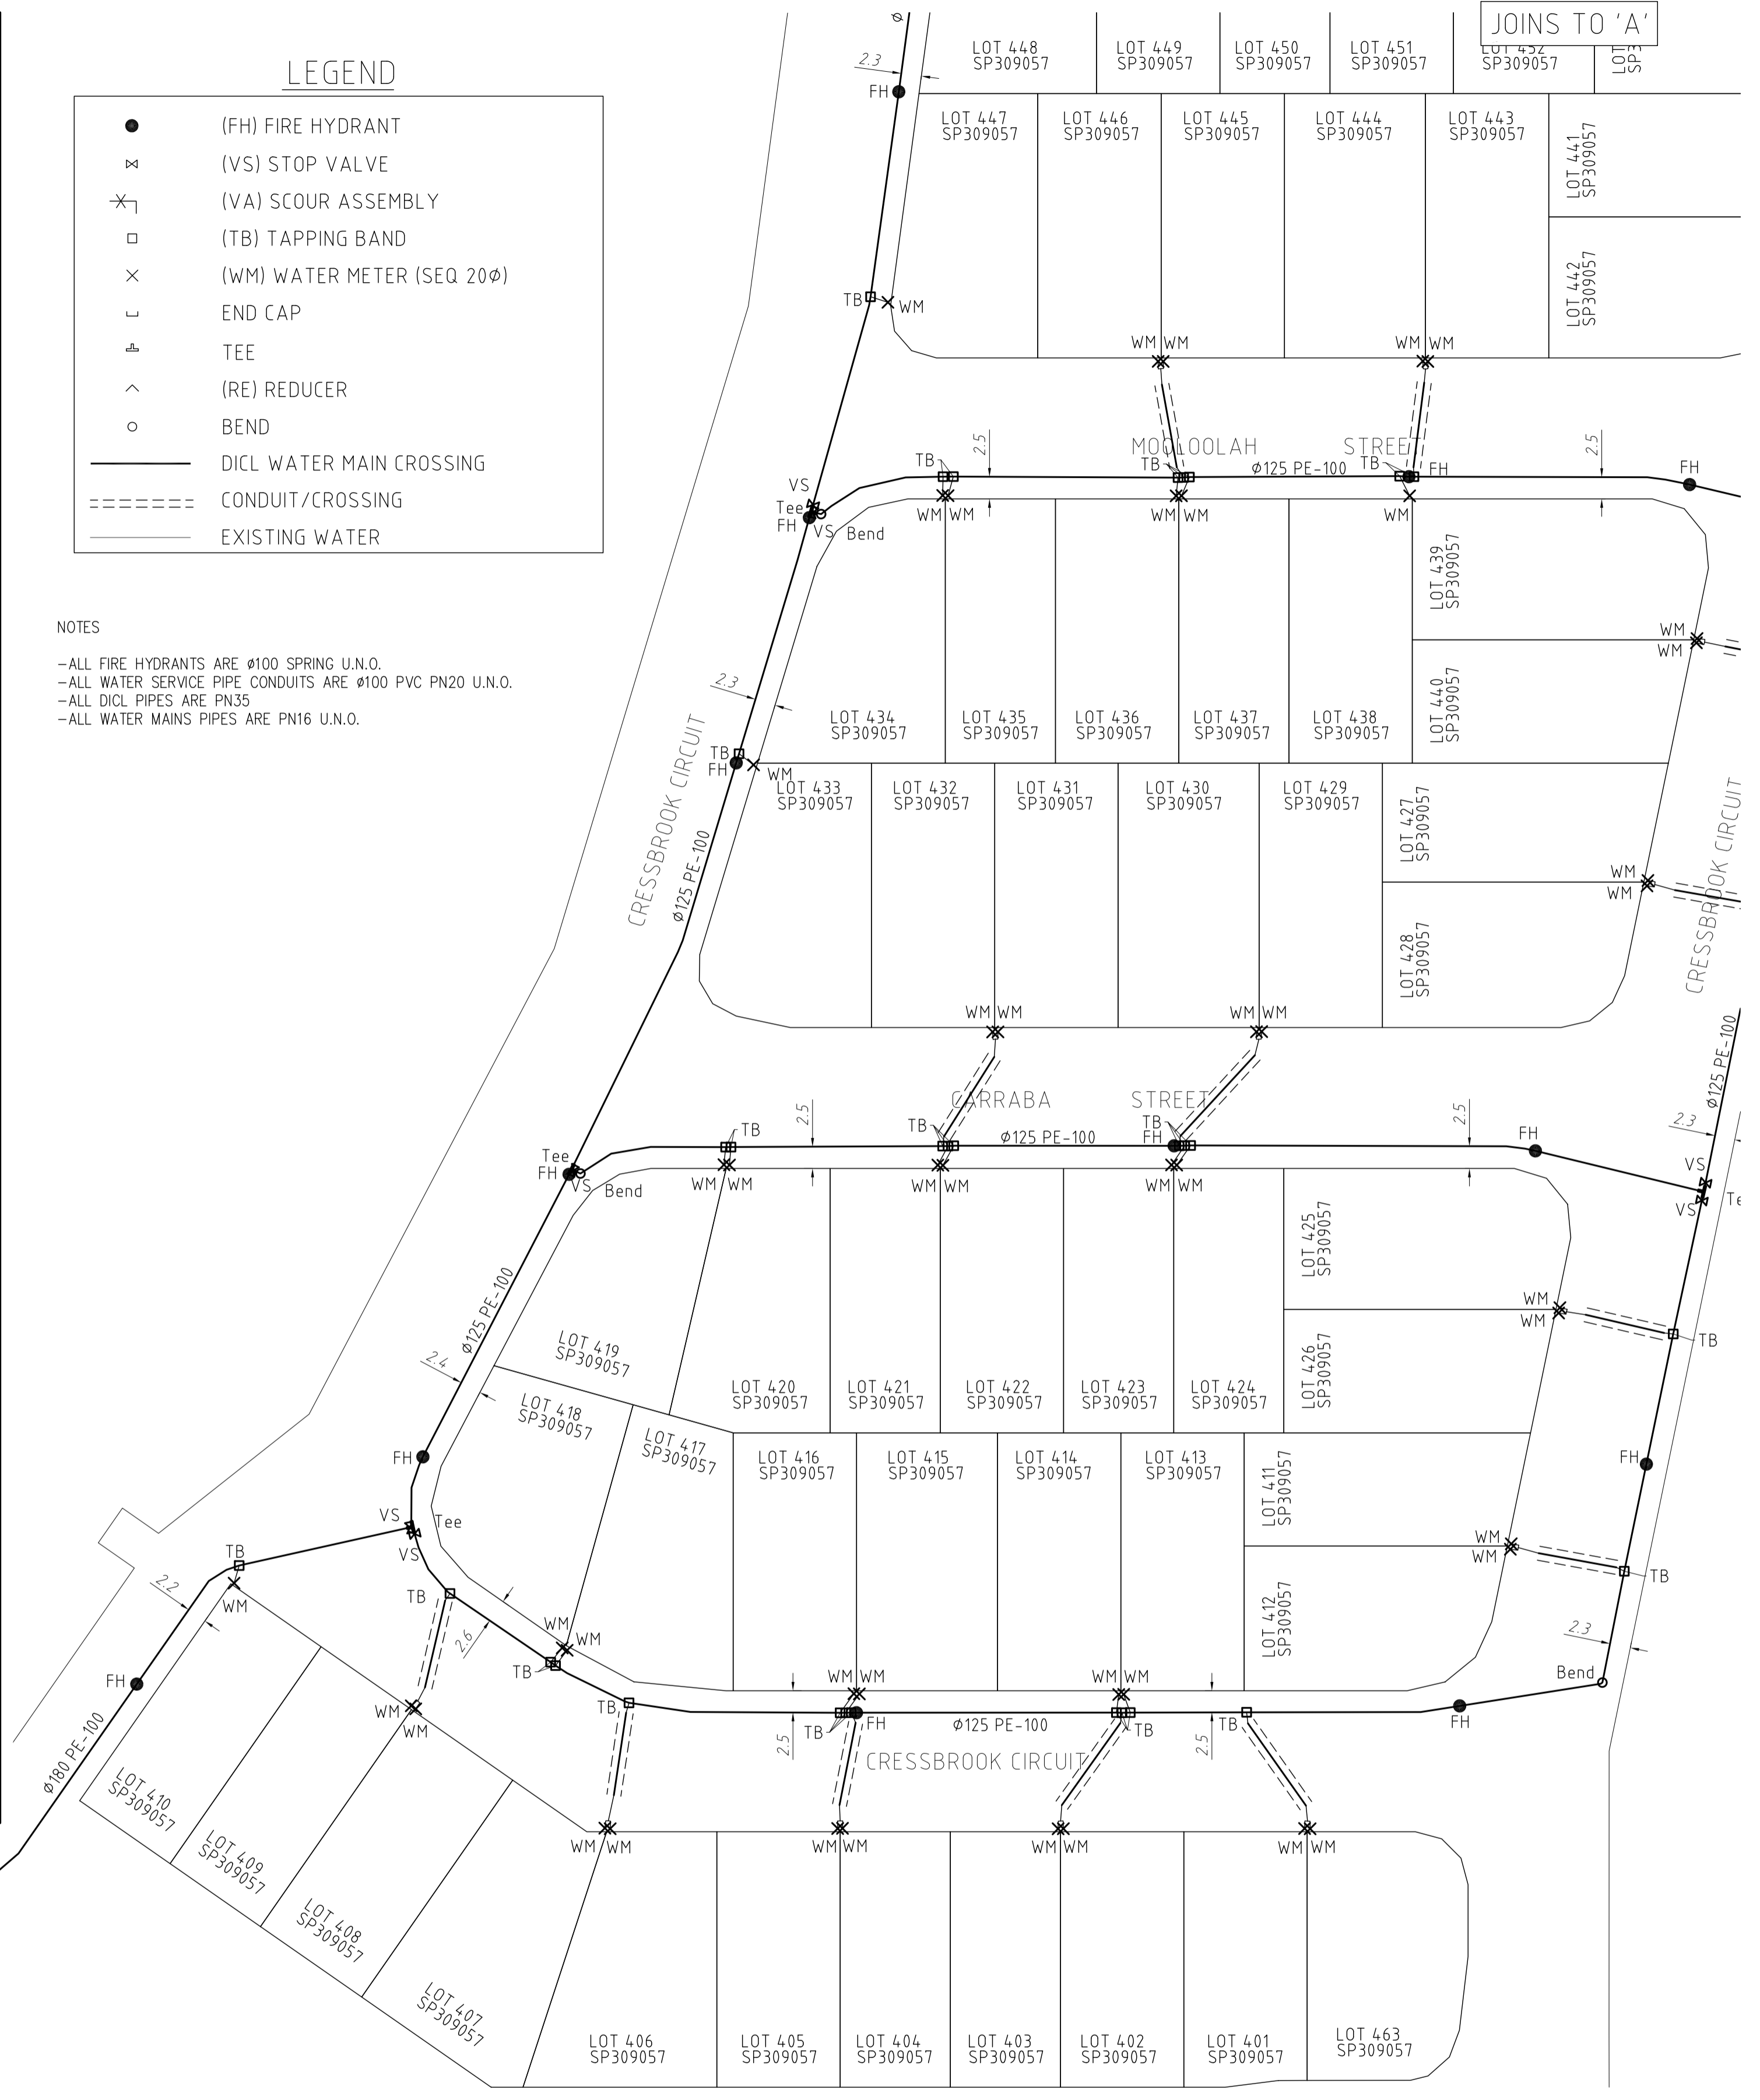

REGISTERED SURVEYOR'S CERTIFICATION
 I, LANDPARTNERS PTY LTD, hereby certify that the vertical and horizontal locations and dimensions shown on this plan are a true and correct record and were located by survey.
 C. Walter
 LandPartners Pty Ltd, Reg. Surveyor No. S4118 Date: 11/09/2020

ENGINEER'S CERTIFICATION
 I, _____, hereby certify that:
 1. The information contained in this drawing / document is in compliance with approved drawings and design.
 2. The new water and sewerage works defined by this drawing have been designed and constructed in accordance with the SEQ Code.
 3. This represents an accurate record of as-constructed works.
 4. I accept responsibility for the information contained in this drawing / document.
 RPEQ (signature) RPEQ No. _____ Date: _____

AS CONSTRUCTED

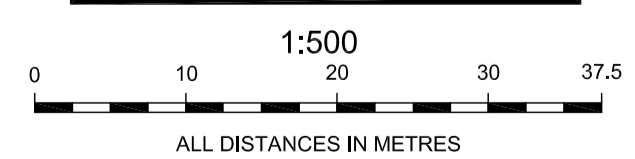

A1	1	11/09/2020	INITIAL ISSUE	B.B	RA	RA
	INDEX	DATE	REVISIONS	DRAWN	CHECKED	PASSED

DRAWN	B.B	11/09/2020
CHECKED	RA	11/09/2020
PASSED	RA	11/09/2020
INITIALS	DATE	



Queensland Urban Utilities
 1 LAKEVIEW DRIVE, DEEBING HEIGHTS
 AS CONSTRUCTED WATER
 19-PNT-43549

SCALE	1:500
SHEET 1 OF 1 SHEETS	
DRAWING NO.	BRSS5365-030-113-1