


REGISTERED SURVEYOR'S CERTIFICATION
 LANDPARTNERS PTY. LTD. hereby certify that the vertical and horizontal locations and dimensions shown on this plan are a true and correct record and were located by survey.
 Rose McDowall (DIRECTOR)
 LandPartners Pty Ltd, Reg. Surveyor No. S4118 Date: 13/01/2022.


ENGINEER'S CERTIFICATION
 I, Troy Schultz, hereby certify that:
 1. The information contained in this drawing / document is in compliance with approved drawings and design.
 2. The new water and sewerage works defined by this drawing have been designed and constructed in accordance with the SEQ Code.
 3. This represents an accurate record of as-constructed works.
 4. I accept responsibility for the information contained in this drawing / document.
 RPEQ (signature) RPEQ No. 20631 Date: 11/02/2022

LEGEND

●	(FH) FIRE HYDRANT
⊗	(VS) STOP VALVE
⊗	(VA) SCOUR ASSEMBLY
□	(TB) TAPPING BAND
⊗	(WM) WATER METER (SEQ 20φ)
└	END CAP
└	TEE
^	REDUCER
○	BEND
—	DICL WATER MAIN CROSSING
- - - -	CONDUIT/CROSSING
—	EXISTING WATER

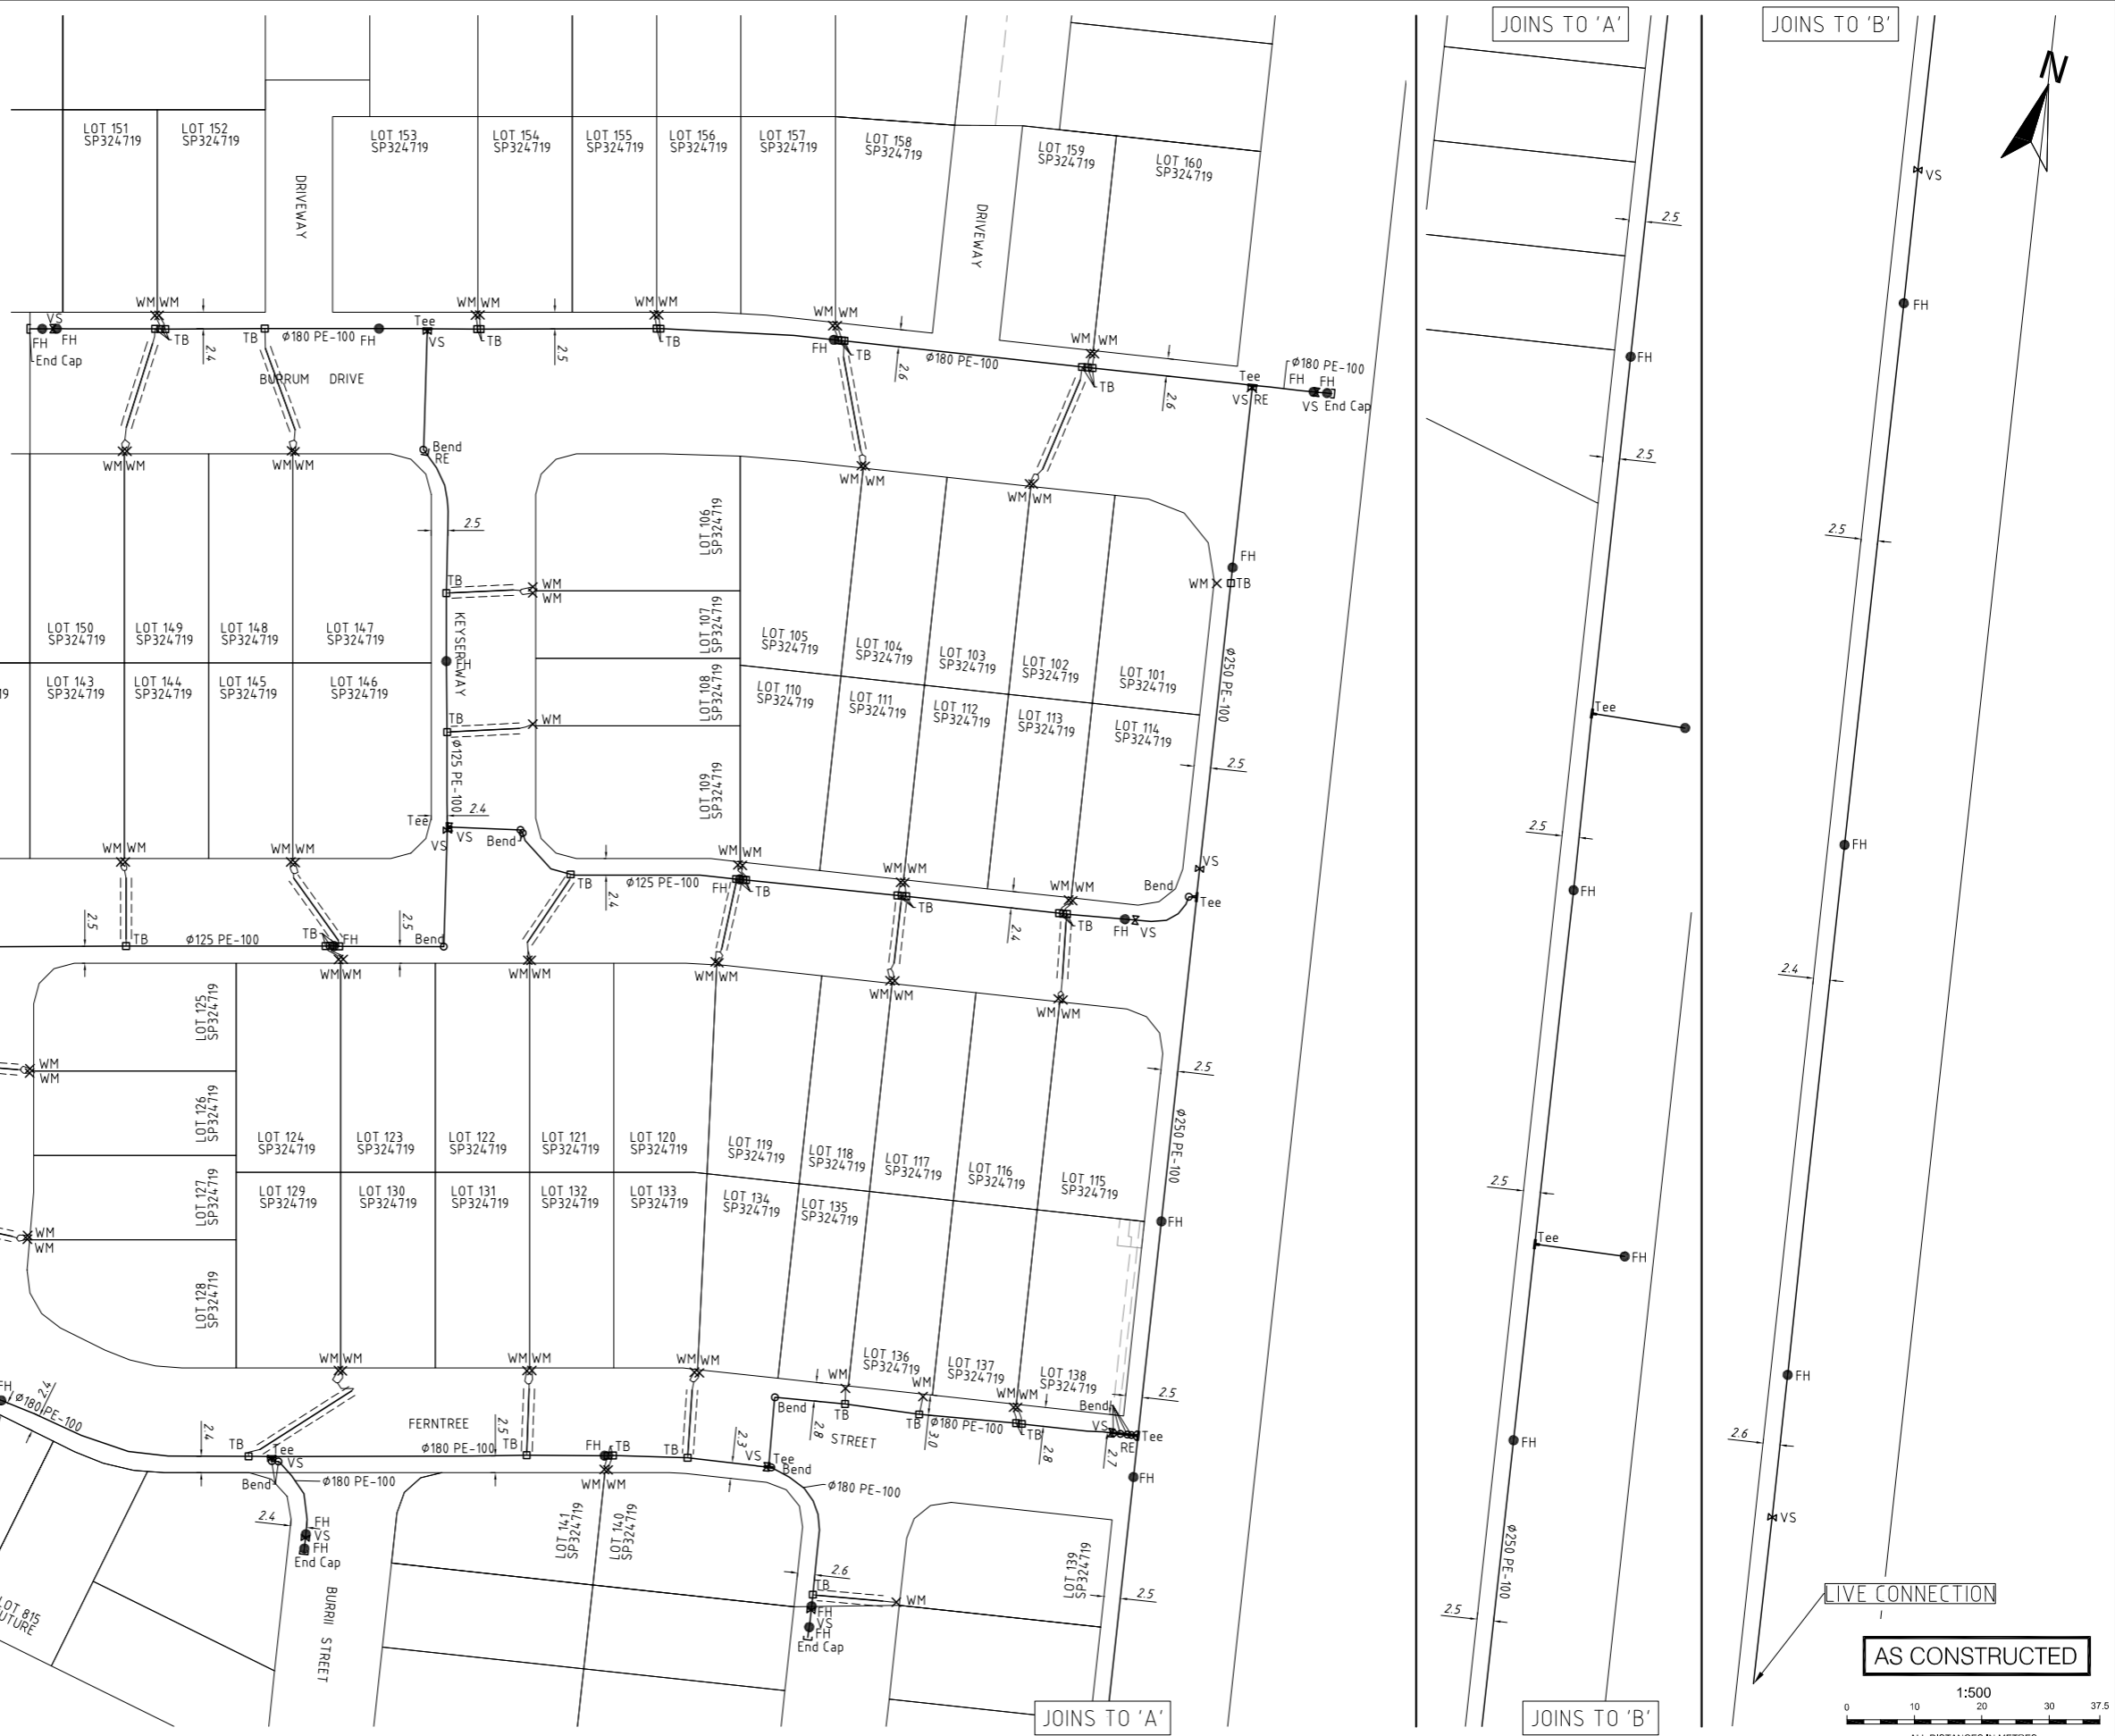

NOTES
 -ALL FIRE HYDRANTS ARE #100 SPRING U.N.O.
 -ALL WATER SERVICE PIPE CONDUITS ARE #100 PVC PN20 U.N.O.
 -ALL DICL PIPES ARE PN35
 -ALL WATER MAINS PIPES ARE PN16 U.N.O.

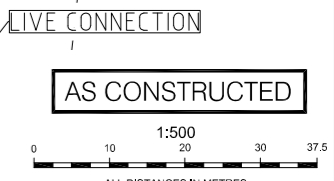

A1	1	13/01/2022	INITIAL ISSUE	BJB	RA	RA
	INDEX	DATE	REVISIONS	DRAWN	CHECKED	PASSED

DRAWN	BJB	13/01/2022
CHECKED	RA	13/01/2022
PASSED	RA	13/01/2022
INITIALS	DATE	



Queensland Urban Utilities
 DALEY'S ROAD, RIPLEY STAGE 1
 AS CONSTRUCTED WATER
 20-PNT-44289

SCALE	1500
SHEET 1	OF 1 SHEETS
DRAWING NO.	BRSS5365-001-93-1