


REGISTERED SURVEYOR'S CERTIFICATION
 LandPartners Pty Ltd hereby certify that the vertical and horizontal locations and dimensions shown on this plan are a true and correct record and were located by survey.
 (Director)
 LandPartners Pty Ltd, Reg. Surveyor No. S4118 Date: 21/12/2022

ENGINEERS CERTIFICATION
 I, _____ hereby certify that:
 1. The information contained in this drawing / document is in compliance with approved drawings and design.
 2. The new water and sewerage works defined by this drawing have been designed and constructed in accordance with the SEQ Code.
 3. This represents an accurate record of as-constructed works.
 4. I accept responsibility for the information contained in this drawing / document.
 RPEQ (signature) RPEQ No. _____ Date: _____

NOTES
 -ALL SEWER HOUSE CONNECTIONS LABELED 'CALC' HAVE DEPTHS DERIVED FROM DESIGN SURFACE.
 -SEWER MAINTENANCE HOLES MH4-20, MH5-20, MS6-20, MH7-20, MS8-20 & MS9-20 HAVE SURFACE LEVELS FROM DESIGN
 -ALL SEWER RETICULATION PIPES ARE #160 PE-100 SDR21 U.N.O.
 -ALL SEWER HOUSE CONNECTION PIPES ARE #110 PE-100 SDR21 U.N.O.

AS CONSTRUCTED

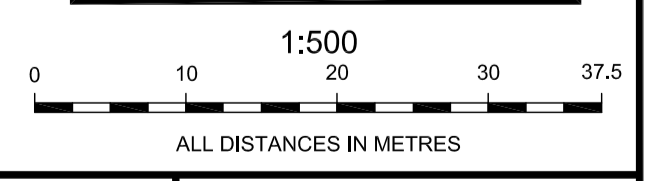



A1	1	21/12/2022	INITIAL ISSUE	B.B	RA	RA
	INDEX	DATE	REVISIONS	DRAWN	CHECKED	PASSED

DRAWN	B.B	21/12/2022
CHECKED	RA	21/12/2022
PASSED	RA	21/12/2022
INITIALS	DATE	



Queensland Urban Utilities
 AURORA STAGE 2
 AS CONSTRUCTED SEWER
 21-PNT-53347

SCALE	1:500
SHEET 1 OF 2 SHEETS	
DRAWING NO.	BRSS5365-002-68-1

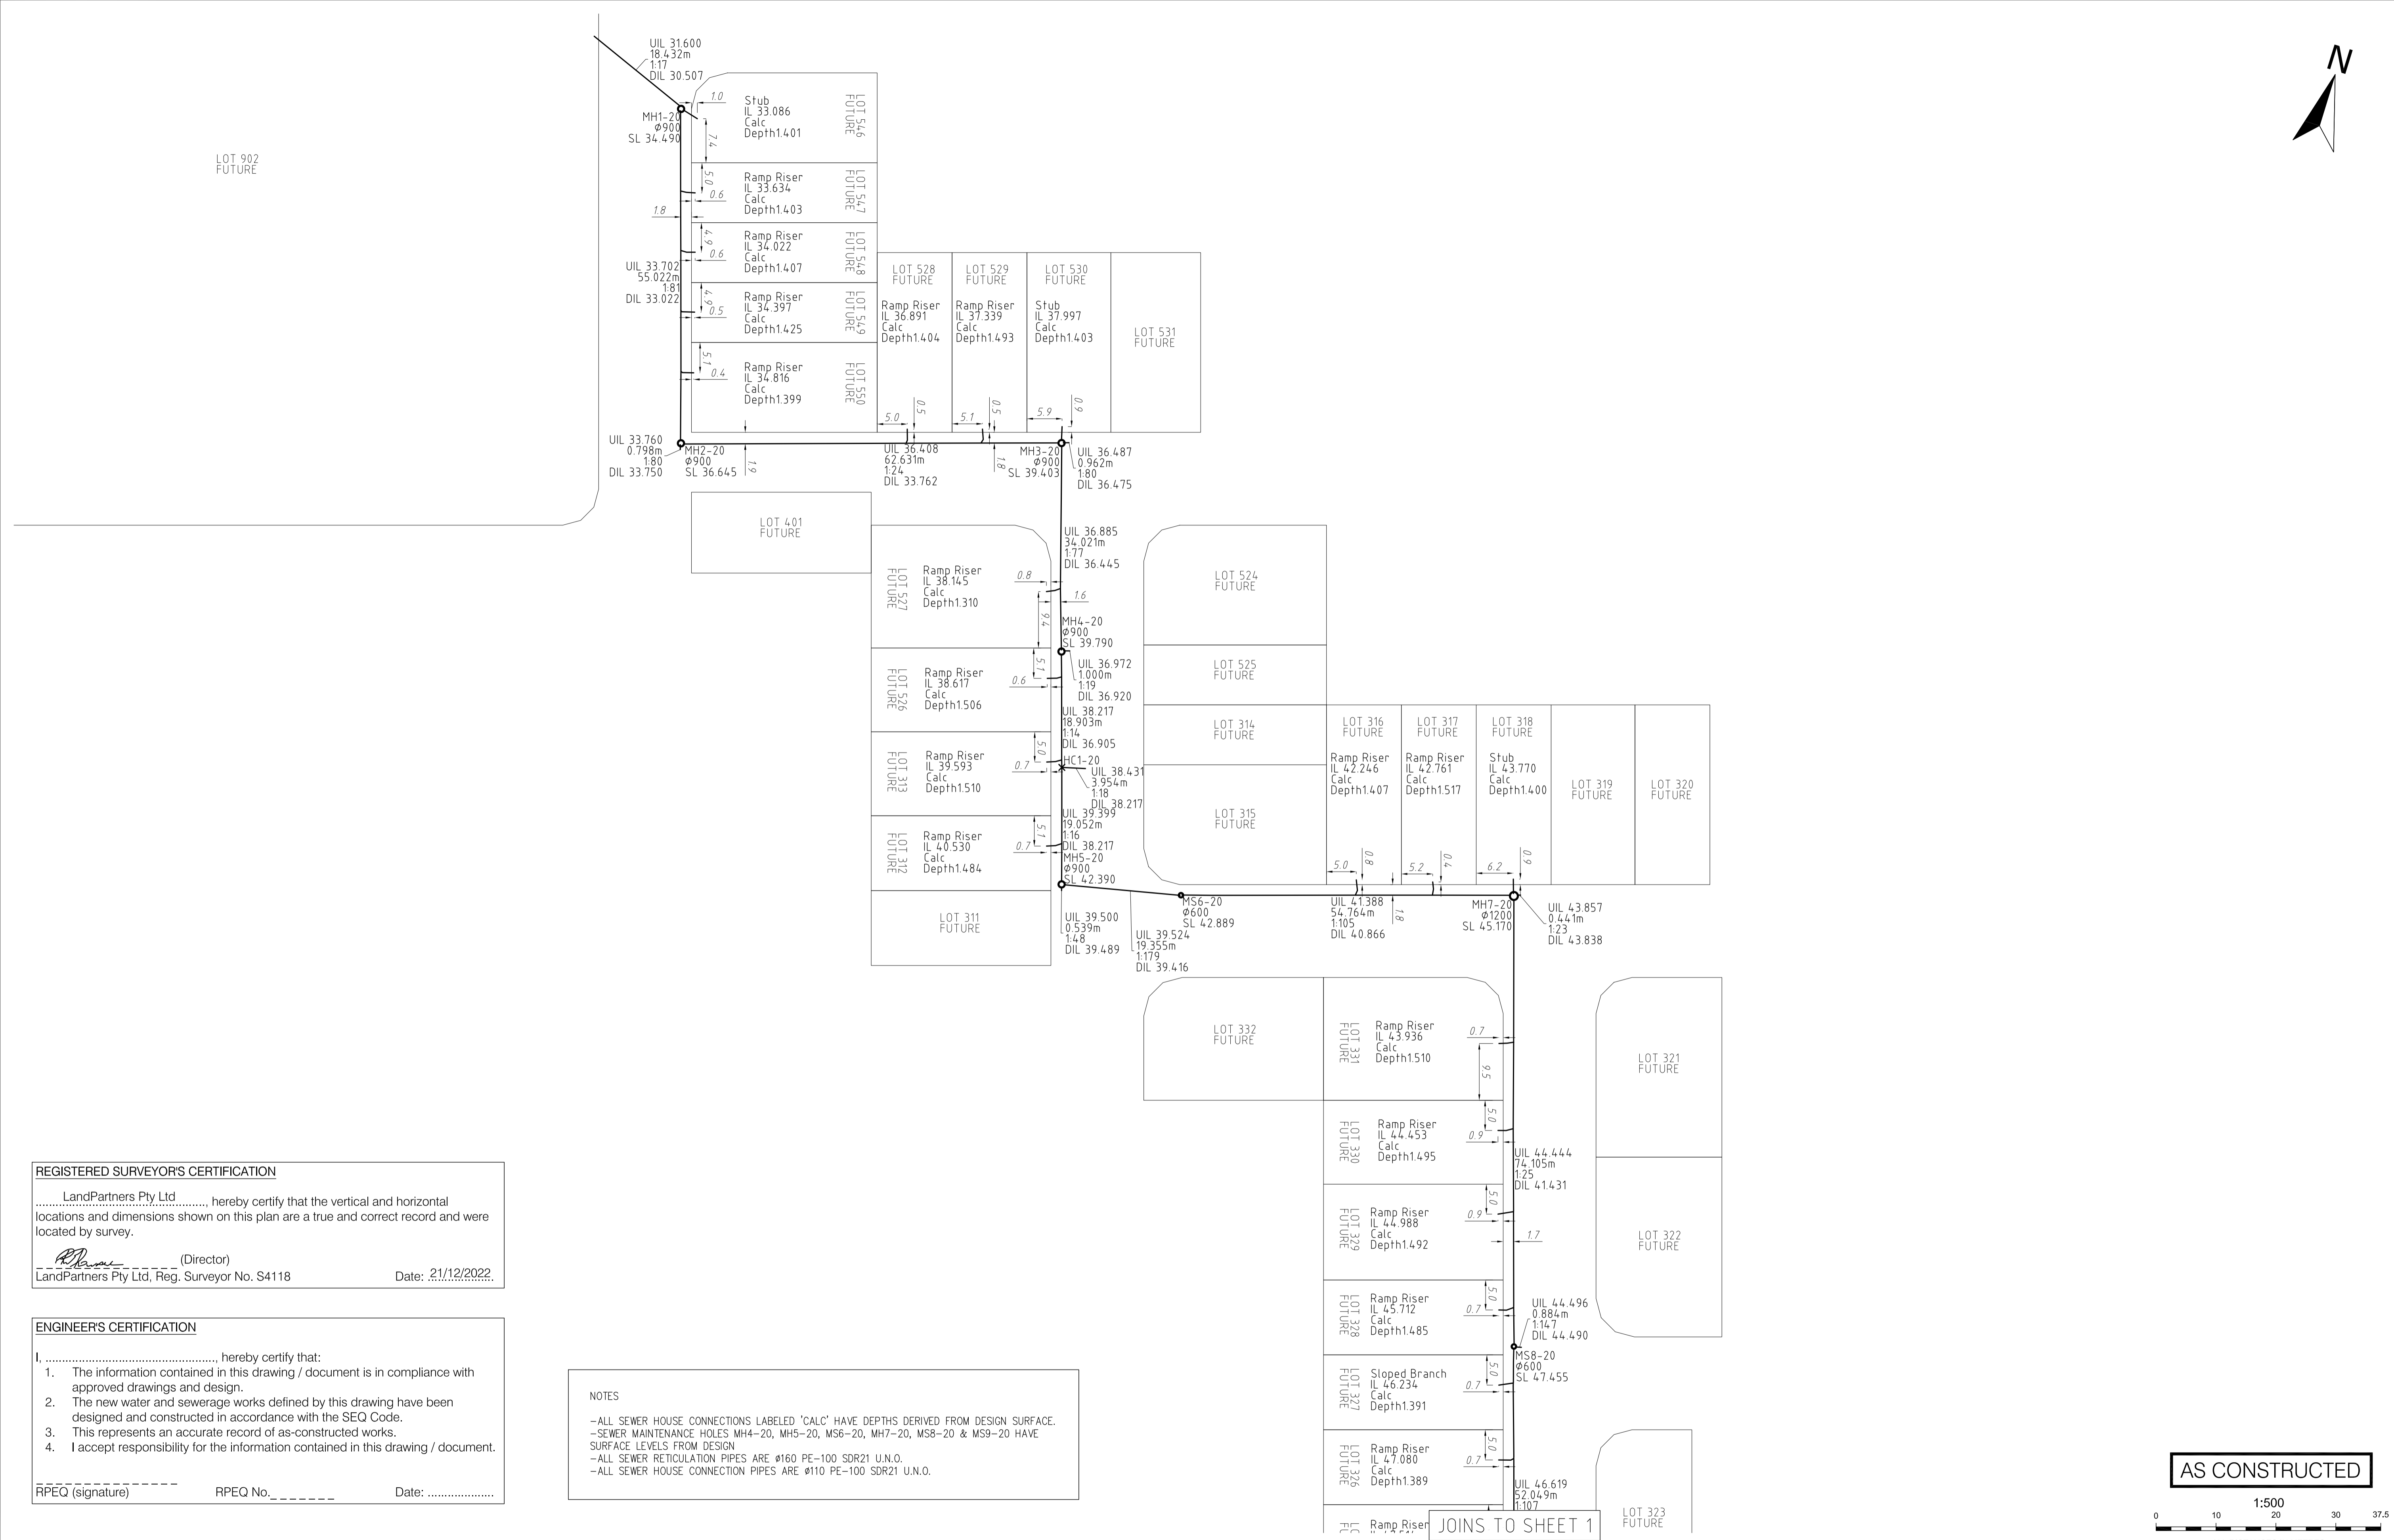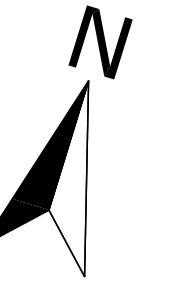


REGISTERED SURVEYOR'S CERTIFICATION
 LandPartners Pty Ltd hereby certify that the vertical and horizontal locations and dimensions shown on this plan are a true and correct record and were located by survey.
 _____ (Director)
 LandPartners Pty Ltd, Reg. Surveyor No. S4118 Date: 21/12/2022

ENGINEERS CERTIFICATION
 I, _____ hereby certify that:
 1. The information contained in this drawing / document is in compliance with approved drawings and design.
 2. The new water and sewerage works defined by this drawing have been designed and constructed in accordance with the SEQ Code.
 3. This represents an accurate record of as-constructed works.
 4. I accept responsibility for the information contained in this drawing / document.
 RPEQ (signature) RPEQ No. _____ Date: _____

NOTES
 -ALL SEWER HOUSE CONNECTIONS LABELED 'CALC' HAVE DEPTHS DERIVED FROM DESIGN SURFACE.
 -SEWER MAINTENANCE HOLES MH4-20, MH5-20, MS6-20, MH7-20, MS8-20 & MS9-20 HAVE SURFACE LEVELS FROM DESIGN
 -ALL SEWER RETICULATION PIPES ARE #160 PE-100 SDR21 U.N.O.
 -ALL SEWER HOUSE CONNECTION PIPES ARE #110 PE-100 SDR21 U.N.O.

AS CONSTRUCTED

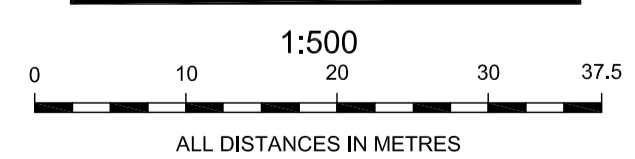

A1	1	21/12/2022	INITIAL ISSUE	B.B	RA	RA
	INDEX	DATE	REVISIONS	DRAWN	CHECKED	PASSED

DRAWN	B.B	21/12/2022
CHECKED	RA	21/12/2022
PASSED	RA	21/12/2022
INITIALS	DATE	



Queensland Urban Utilities
 AURORA STAGE 2
 AS CONSTRUCTED SEWER
 21-PNT-53347

SCALE	1:500
SHEET 2	OF 2 SHEETS
DRAWING NO.	BRSS5365-002-68-1