

AS CONSTRUCTED CERTIFICATION

I, _____ (Company's representative Name) _____ (Signature)
 _____ (Date) _____ (RPED)
 Being a duly representative of- _____ (Company Name)

Hereby certify that

- The information contained in this drawing / document is in compliance with approved drawings and design supplied under the terms of the contract.
- This represents an accurate "As constructed" record of works carried out and accept responsibility for the information contained in this drawing / document.

REGISTERED SURVEYOR'S CERTIFICATION


I, LANDPARTNERS PTY LTD, hereby certify that the vertical and horizontal locations and dimensions shown on this plan are a true and correct record and were located by survey.

R. Davis (DIRECTOR)
 Registered Surveyor (sig) Reg. Surveyor No. SL418 Date: 22/12/2022

NOTES

- ALL STORMWATER PIPES ARE RCP '3' U.N.O.

AS CONSTRUCTED

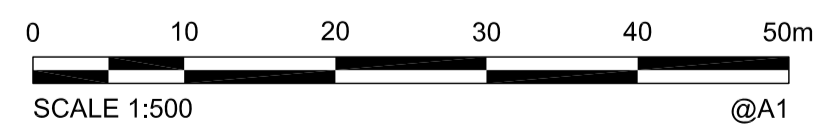

COORDINATE DATUM NOTE:
 HORIZONTAL COORDINATES (E,N) SUPPLIED ARE MAPPING GRID OF AUSTRALIA (MGA), ZONE 56 BASED ON THE UNIVERSAL TRANSVERSE MERCATOR PROJECTION AND THE GEOCENTRIC DATUM OF AUSTRALIA 2020.

A1									
	1	22/12/2022	INITIAL ISSUE				BJB	RA	RA
	INDEX	DATE	REVISIONS	DRAWN	CHECKED	PASSED			



IPSWICH CITY COUNCIL

AURORA STAGE 2
 AS CONSTRUCTED STORMWATER
 15/6/2020/PDA

SCALE 1500
 SHEET 1 OF 1 SHEETS
 DRAWING NO.
 BRSS5365-002-73-1