


REGISTERED SURVEYOR'S CERTIFICATION
 LandPartners Pty Ltd hereby certify that the vertical and horizontal locations and dimensions shown on this plan are a true and correct record and were located by survey.
R. G. Andrew
 LandPartners Pty Ltd, Reg. Surveyor No. S4118 Date: 16/03/2023

ENGINEERS CERTIFICATION
 I, _____, hereby certify that:
 1. The information contained in this drawing / document is in compliance with approved drawings and design.
 2. The new water and sewerage works defined by this drawing have been designed and constructed in accordance with the SEQ Code.
 3. This represents an accurate record of as-constructed works.
 4. I accept responsibility for the information contained in this drawing / document.
 RPEQ (signature) RPEQ No. _____ Date: _____

NOTES
 -ALL SEWER RETICULATION PIPES ARE Ø160 PE-100 SDR21 U.N.O.
 -ALL SEWER HOUSE CONNECTION PIPES ARE Ø110 PE-100 SDR21 U.N.O.

AS CONSTRUCTED

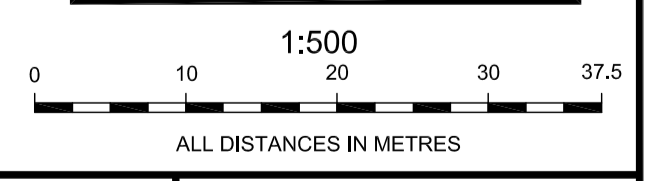

A1	1	15/03/2023	INITIAL ISSUE	B.B	RA	RA
	INDEX	DATE	REVISIONS	DRAWN	CHECKED	PASSED

DRAWN	B.B	15/03/2023
CHECKED	RA	16/03/2023
PASSED	RA	16/03/2023
INITIALS	DATE	



Queensland Urban Utilities
 AURORA STAGE 3
 AS CONSTRUCTED SEWER
 21-PNT-54735

SCALE	1:500
SHEET 1 OF 1 SHEETS	
DRAWING NO.	BRSS5365-003-70-1