

REGISTERED SURVEYOR'S CERTIFICATION

I, LandPartners Pty.Ltd., hereby certify that the vertical and horizontal locations and dimensions shown on this plan are a true and correct record and were located by survey.

C. Walters
Registered Surveyor (sig.) Reg. Surveyor No. SL4118 Date: 23/03/2023

AS CONSTRUCTED CERTIFICATION

I, _____ (Company's representative Name) _____ (Signature)
_____, _____ (Date) _____ (RPEQ)
Being a duty representative of: _____ (Company Name)


Hereby certify that

- The information contained in this drawing / document is in compliance with approved drawings and design supplied under the terms of the contract.
- This represents an accurate "As constructed" record of works carried out and accept responsibility for the information contained in this drawing / document.

NOTES

-ALL STORMWATER PIPES ARE RCP '3' U.N.O.

COORDINATE DATUM NOTE:
HORIZONTAL COORDINATES (E,N) SUPPLIED ARE MAPPING GRID OF AUSTRALIA (MGA), ZONE 56 BASED ON THE UNIVERSAL TRANSVERSE MERCATOR PROJECTION AND THE GEOCENTRIC DATUM OF AUSTRALIA 2020.

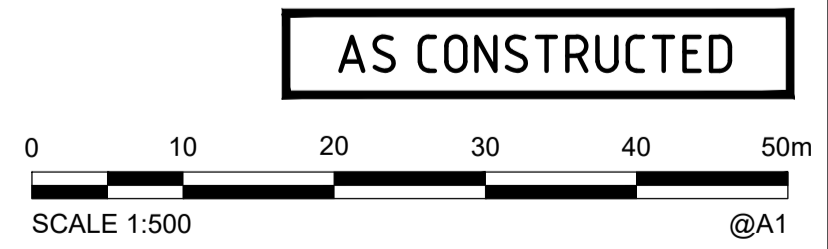

AS CONSTRUCTED

A1	1	24/03/2023	INITIAL ISSUE	BBB	RA	CW
	INDEX	DATE	REVISIONS	DRAWN	CHECKED	PASSED

DRAWN	BBB	16/03/2023
CHECKED	RA	24/03/2023
PASSED	CW	24/03/2023
INITIALS	DATE	



IPSWICH CITY COUNCIL

AURORA STAGE 3
AS CONSTRUCTED STORMWATER
15/46/2020/PDA

SCALE 1500
SHEET 1 OF 1 SHEETS
DRAWING NO.
BRSS5365-003-73-1