


**REGISTERED SURVEYOR'S CERTIFICATION**  
 LandPartners Pty Ltd hereby certify that the vertical and horizontal locations and dimensions shown on this plan are a true and correct record and were located by survey.  
*C. Walters*  
 LandPartners Pty Ltd, Reg. Surveyor No. S4118 Date: 26/06/2023

**ENGINEER'S CERTIFICATION**  
 I, \_\_\_\_\_, hereby certify that:  
 1. The information contained in this drawing / document is in compliance with approved drawings and design.  
 2. The new water and sewerage works defined by this drawing have been designed and constructed in accordance with the SEQ Code.  
 3. This represents an accurate record of as-constructed works.  
 4. I accept responsibility for the information contained in this drawing / document.  
 RPEQ (signature) RPEQ No. \_\_\_\_\_ Date: \_\_\_\_\_

**AS CONSTRUCTED**

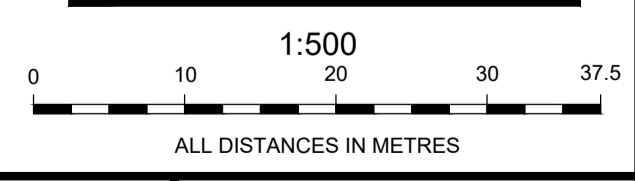

<b>A1</b>	1	26/06/2023	INITIAL ISSUE	MK	VO	CGW
	INDEX	DATE	REVISIONS	DRAWN	CHECKED	PASSED

DRAWN	MK	26/06/2023
CHECKED	VO	26/06/2023
PASSED	CGW	26/06/2023
INITIALS	DATE	

**LANDPARTNERS**  
 surveyors and planners  
 Brisbane Office  
 Level 1  
 18 Little Crabb Street  
 Milton Qld 4004  
 PO Box 1189  
 Milton Qld 4004  
 Phone: (07) 3842 1000  
 Email: info@landpartners.com.au  
 Website: www.landpartners.com.au

**QUEENSLAND**  
**Urban Utilities**

**Queensland Urban Utilities**  
 AURORA STAGE 4  
 AS CONSTRUCTED SEWER  
 22-PNT-56794

SCALE	1:500
SHEET 1 OF 1 SHEETS	
DRAWING NO.	BRSS5365-004-82-1