


**NOTES**

- ALL STORMWATER PIPES ARE RCP '3'.
- ALL STORMWATER PVC PIPES ARE CLASS 'B'.

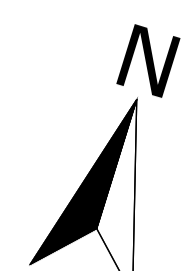

**REGISTERED SURVEYOR'S CERTIFICATION**

I, LandPartners Pty Ltd., hereby certify that the vertical and horizontal locations and dimensions shown on this plan are a true and correct record and were located by survey.

*C. Walters*  
Registered Surveyor (sig) Reg. Surveyor No. 54118 Date: 13/07/2023



**AS CONSTRUCTED CERTIFICATION**

I, \_\_\_\_\_ (Company's representative Name) \_\_\_\_\_ (Signature)  
\_\_\_\_\_, \_\_\_\_\_ (Date) \_\_\_\_\_ (RPEQ)  
Being a duly representative of: \_\_\_\_\_ (Company Name)

Hereby certify that

- The information contained in this drawing / document is in compliance with approved drawings and design supplied under the terms of the contract.
- This represents an accurate "As constructed" record of works carried out and accept responsibility for the information contained in this drawing / document.

**COORDINATE DATUM NOTE:**  
HORIZONTAL COORDINATES (E,N) SUPPLIED ARE MAPPING GRID OF AUSTRALIA (MGA), ZONE 56 BASED ON THE UNIVERSAL TRANSVERSE MERCATOR PROJECTION AND THE GEOCENTRIC DATUM OF AUSTRALIA 2020.

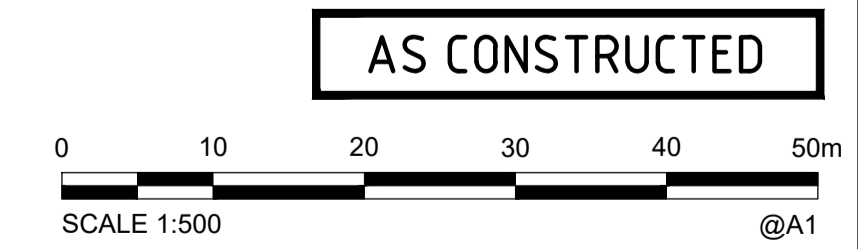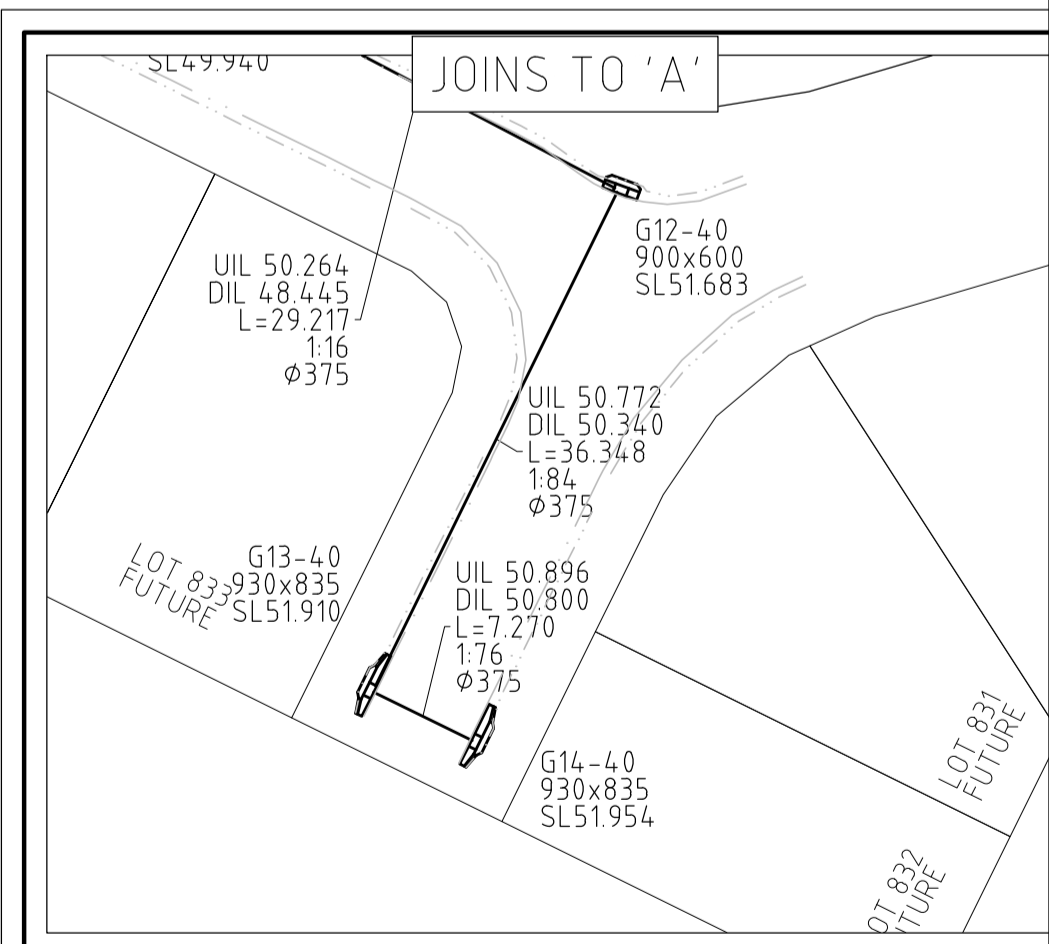


<b>A1</b>	1	13/07/2023	INITIAL ISSUE	MK	VO	CGW
	INDEX	DATE	REVISIONS	DRAWN	CHECKED	PASSED

DRAWN	MK	13/07/2023
CHECKED	VO	13/07/2023
PASSED	CGW	13/07/2023
INITIALS	DATE	

**LANDPARTNERS**  
surveyors and planners

Brisbane Office  
Level 1  
18 Little Cribb Street  
Milton Qld 4064  
PO Box 1389  
Milton Qld 4064  
P: (07) 3842 1000  
E: info@landpartners.com.au  
W: www.landpartners.com.au

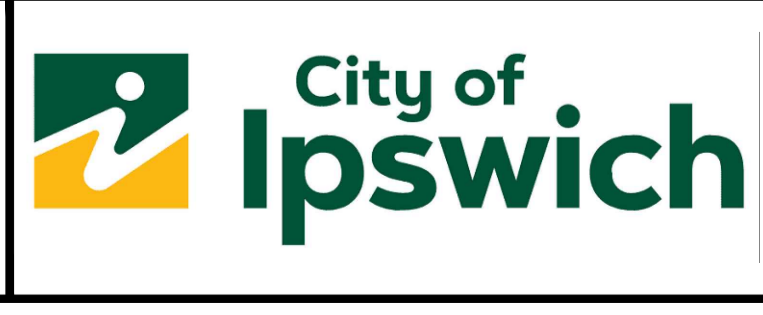

**IPSWICH CITY COUNCIL**

AURORA STAGE 4  
AS CONSTRUCTED STORMWATER  
15/6/2020/PDA

SCALE	1:500
SHEET	1 OF 1 SHEETS
DRAWING NO.	BRJ05365-004-85-1