


ENGINEERS CERTIFICATION
 I, _____, hereby certify that:
 1. The information contained in this drawing / document is in compliance with approved drawings and design.
 2. The new water and sewerage works defined by this drawing have been designed and constructed in accordance with the SEQ Code.
 3. This represents an accurate record of as-constructed works.
 4. I accept responsibility for the information contained in this drawing / document.
 RPEQ (signature) _____ RPEQ No. _____ Date: _____



A1	INDEX	DATE	INITIALS	REVISIONS	DRAWN	CHECKED	PASSED
	1	8/09/2023	MJK	INITIAL ISSUE	MJK	VO	CGW

DRAWN	MJK	8/09/2023
CHECKED	VO	8/09/2023
PASSED	CGW	8/09/2023
INITIALS	DATE	

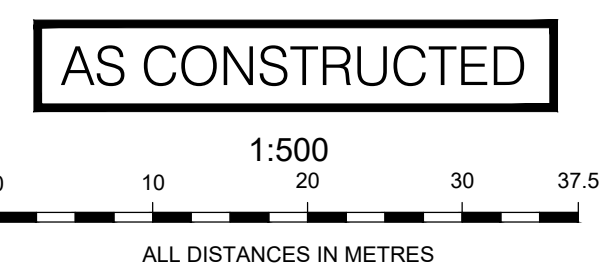

Queensland Urban Utilities
 AURORA STAGE 5
 AS CONSTRUCTED WATER
 22-PNT-56794

SCALE	1500
SHEET 1 OF 1 SHEETS	
DRAWING NO.	BRSS5365-005-77-1