


**REGISTERED SURVEYOR'S CERTIFICATION**  
 Landpartners Pty Ltd, hereby certify that the vertical and horizontal locations and dimensions shown on this plan are a true and correct record and were located by survey.  
*C. Walters*  
 LandPartners Pty Ltd, Reg. Surveyor No. S4118 Date: ...8/09/2023...

**ENGINEERS CERTIFICATION**  
 I, \_\_\_\_\_, hereby certify that:  
 1. The information contained in this drawing / document is in compliance with approved drawings and design.  
 2. The new water and sewerage works defined by this drawing have been designed and constructed in accordance with the SEQ Code.  
 3. This represents an accurate record of as-constructed works.  
 4. I accept responsibility for the information contained in this drawing / document.  
 RPEQ (signature) \_\_\_\_\_ RPEQ No. \_\_\_\_\_ Date: \_\_\_\_\_

**AS CONSTRUCTED**

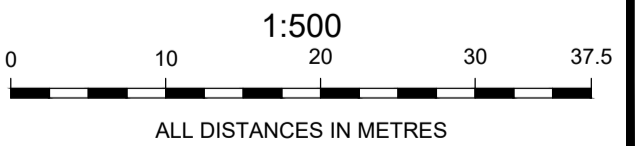

**A1**

INDEX	DATE	INITIALS	REVISIONS	DRAWN	CHECKED	PASSED
1	8/09/2023		INITIAL ISSUE	MJK	VO	CGW

DRAWN	CHECKED	PASSED	INITIALS	DATE
MJK	VO	CGW		8/09/2023
				8/09/2023
				8/09/2023

**LANDPARTNERS**  
 surveyors and planners  
 Brisbane Office  
 Level 1  
 18 Little Cribb Street  
 Milton QLD 4064  
 PO Box 1399  
 Milton QLD 4064  
 P: (07) 3842 1000  
 F: (07) 3842 1001  
 E: info@landpartners.com.au  
 W: www.landpartners.com.au



**Queensland Urban Utilities**

AURORA STAGE 5  
 AS CONSTRUCTED SEWER  
 22-PNT-56794

SCALE 1500  
 SHEET 1 OF 1 SHEETS  
 DRAWING NO.  
 BRSS5365-005-78-1