


NOTES
 -ALL STORMWATER PIPES ARE RCP '3'.

REGISTERED SURVEYOR'S CERTIFICATION
 LandPartners Pty Ltd, hereby certify that the vertical and horizontal locations and dimensions shown on this plan are a true and correct record and were located by survey.
C. Walters
 Registered Surveyor (sig) Reg. Surveyor No. _____ Date: 6/09/2023


AS CONSTRUCTED CERTIFICATION
 I, _____ (Company's representative Name) Signature: _____
 (Date) (RPEQ)
 Being a duly representative of: _____ (Company Name)
 Hereby certify that
 1. The information contained in this drawing / document is in compliance with approved drawings and design supplied under the terms of the contract.
 2. This represents an accurate "As constructed" record of works carried out and accept responsibility for the information contained in this drawing / document.

COORDINATE DATUM NOTE:
 HORIZONTAL COORDINATES (E,N) SUPPLIED ARE MAPPING GRID OF AUSTRALIA (MGA), ZONE 56 BASED ON THE UNIVERSAL TRANSVERSE MERCATOR PROJECTION AND THE GEOCENTRIC DATUM OF AUSTRALIA 2020.

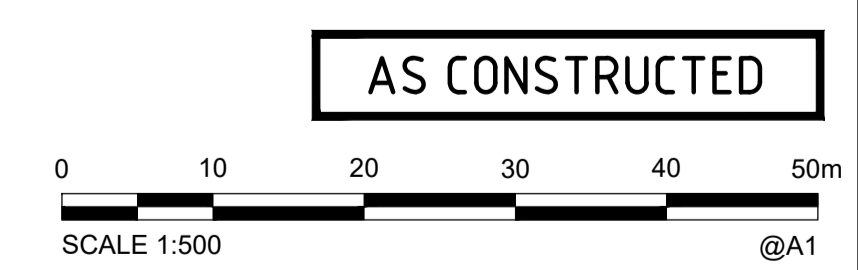

A1	1	6/09/2023	INITIAL ISSUE	MJK	VO	CGW
	INDEX	DATE	REVISIONS	DRAWN	CHECKED	PASSED

DRAWN	MJK	6/09/2023
CHECKED	VO	6/09/2023
PASSED	CGW	6/09/2023
INITIALS	DATE	

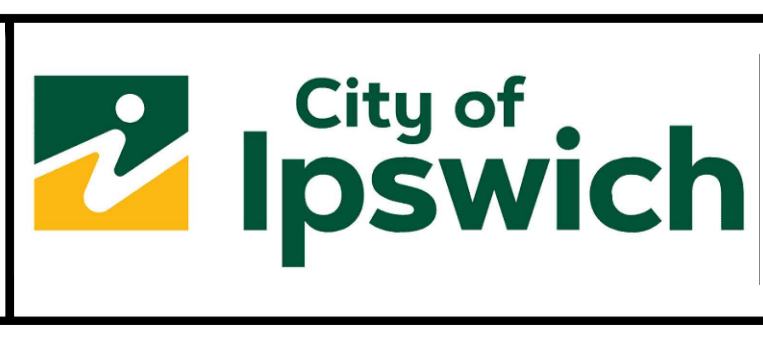

IPSWICH CITY COUNCIL
 AURORA STAGE 5
 AS CONSTRUCTED STORMWATER
 15/6/2020/PDA

SCALE	1:500
SHEET	1 OF 1 SHEETS
DRAWING NO.	BRSS5365-005-74-1