

LEGEND

- (FH) FIRE HYDRANT
- ⊗ (VS) STOP VALVE
- (TB) TAPPING BAND
- × (WM) WATER METER (SEQ 20φ)
- └ END CAP
- └ TEE
- ^ REDUCER
- BEND
- DICL PIPE
- CONDUIT/CROSSING
- EXISTING WATER

ENGINEER'S CERTIFICATION

I, _____, hereby certify that:

- The information contained in this drawing / document is in compliance with approved drawings and design.
- The new water and sewerage works defined by this drawing have been designed and constructed in accordance with the SEQ Code.
- This represents an accurate record of as-constructed works.
- I accept responsibility for the information contained in this drawing / document.

RPEQ (signature) _____ RPEQ No. _____ Date: _____

REGISTERED CADASTRAL SURVEYOR (QLD) CERTIFICATION

LandPartners Pty Ltd, hereby certify that the horizontal and vertical locations, and dimensions shown on this plan are a true and correct record of the As Constructed information.


Signed: *R. G. Andrew* Date: 9/09/2024
(Authorised Delegate)

LandPartners Pty Ltd, Registered Cadastral Surveyor SBQ ID 4118

NOTES

- ALL FIRE HYDRANTS ARE #100 SPRING U.N.O.
- ALL WATER SERVICE PIPE CONDUITS ARE #100 PVC-M PN12 U.N.O.
- ALL DICL PIPES ARE PN35
- ALL WATER MAINS PIPES ARE PN16 U.N.O.

AS CONSTRUCTED

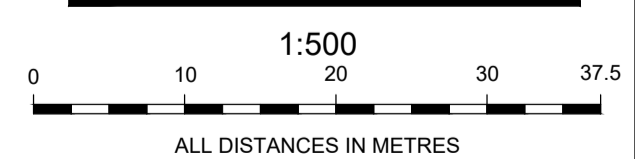

A1	1	9/09/2024	INITIAL ISSUE	MK	RA	RA
	INDEX	DATE	REVISIONS	DRAWN	CHECKED	PASSED

DRAWN	MJK	9/09/2024
CHECKED	RA	9/09/2024
PASSED	RA	9/09/2024
INITIALS		DATE



Queensland Urban Utilities

AURORA STAGE 6
AS-CONSTRUCTED WATER
23-PNT-66906

SCALE 1:500
SHEET 1 OF 1 SHEETS
DRAWING NO.
BRSS5365-006-68-1