

ENGINEER'S CERTIFICATION

I, _____, hereby certify that:

- The information contained in this drawing / document is in compliance with approved drawings and design.
- The new water and sewerage works defined by this drawing have been designed and constructed in accordance with the SEQ Code.
- This represents an accurate record of as-constructed works.
- I accept responsibility for the information contained in this drawing / document.

RPEQ (signature) _____ RPEQ No. _____ Date: _____

REGISTERED CADASTRAL SURVEYOR (QLD) CERTIFICATION


LandPartners Pty Ltd, hereby certify that the vertical and horizontal locations and dimensions shown on this plan are a true and correct record and were located by survey.

R. G. Andrew 4118 6/12/2024
 Authorised Delegate Rego No. Date
 LandPartners Pty Ltd
 Registered Qld Surveyor Corporation

NOTES

- ALL SEWER RETICULATION PIPES ARE 160 PE-100 SDR21 U.N.O.
- ALL SEWER HOUSE CONNECTION PIPES ARE 110 PE-100 SDR21 U.N.O.

AS CONSTRUCTED

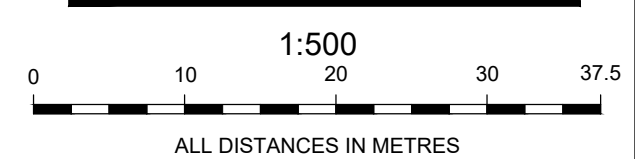

A1	2	6/12/2024	LOT 816 HC AMENDS	MK	RA	RA	
	1	9/09/2024	INITIAL ISSUE	MK	RA	RA	
REVISIONS				DRAWN	CHECKED	PASSED	
INDEX	DATE			INITIALS		DATE	

LANDPARTNERS
 surveyors and planners

PO Box 1399 Milton QLD 4054

P (07) 3842 1000
 F (07) 3842 1001
 E info@landpartners.com.au
 W www.landpartners.com.au

DRAWN MK 6/12/2024
 CHECKED RA 6/12/2024
 PASSED RA 6/12/2024



Queensland Urban Utilities

AURORA STAGE 6
 AS-CONSTRUCTED SEWER
 23-PNT-66906

SCALE 1:500
 SHEET 1 OF 1 SHEETS
 DRAWING NO.
 BRSS5365-006-67-2