

NOTES

- ALL SEWER RETICULATION PIPES ARE Ø160 PE-100 SDR21 U.N.O.
- ALL SEWER HOUSE CONNECTION PIPES ARE PE-100 SDR21 U.N.O.

REGISTERED CADASTRAL SURVEYOR (OLD) CERTIFICATION

LandPartners Pty Ltd, hereby certify that the vertical and horizontal locations and dimensions shown on this plan are a true and correct record and were located by survey.

R. G. Andrew 4118 28/03/2025
 Authorised Delegate Rego No. Date
 LandPartners Pty Ltd
 Registered Qld Surveyor Corporation


ENGINEERS CERTIFICATION

I, _____, hereby certify that:

- The information contained in this drawing / document is in compliance with approved drawings and design.
- The new water and sewerage works defined by this drawing have been designed and constructed in accordance with the SEQ Code.
- This represents an accurate record of as-constructed works.
- I accept responsibility for the information contained in this drawing / document.

RPEQ (signature) RPEQ No. Date:

AS CONSTRUCTED

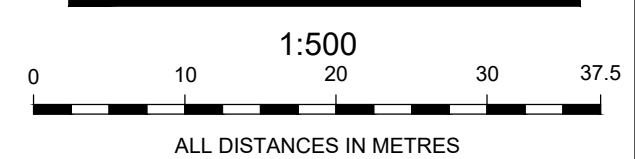

A1	1	27/03/2025	INITIAL ISSUE	MK	RA	RA	<p style="font-size: 8px; margin: 0;">Brisbane Office Level 1 18 Little Cuba Street Milton QLD 4064 PO Box 1399 Milton QLD 4064 P (07) 3842 1000 F (07) 3842 1001 E info@landpartners.com.au www.landpartners.com.au</p>	<p style="font-size: 8px; margin: 0;">Queensland Urban Utilities AURORA STAGE 7 AS-CONSTRUCTED SEWER 23-PNT-66894</p>	SCALE 1:500
	INDEX	DATE	REVISIONS	DRAWN	CHECKED	PASSED			INITIALS