

**REGISTERED CADASTRAL SURVEYOR (QLD) CERTIFICATION**  
 LandPartners Pty Ltd, hereby certify that the horizontal and vertical locations, and dimensions shown on this plan are a true and correct record of the As Constructed information.

*R. G. Andrew* 4118 1/04/2025  
 Authorised Delegate Rego No. Date  
 LandPartners Pty Ltd  
 Registered Qld Surveyor Corporation


**AS CONSTRUCTED CERTIFICATION**

I, \_\_\_\_\_ (Company's representative Name) (Signature)  
 \_\_\_\_\_ (Date) (RPEQ)  
 Being a duly representative of:- \_\_\_\_\_ (Company Name)

Hereby certify that  
 1. The information contained in this drawing / document is in compliance with approved drawings and design supplied under the Terms of the contract.  
 2. This represents an accurate "As constructed" record of works carried out and accept responsibility for the information contained in this drawing / document.

**NOTES**  
 -ALL STORMWATER PIPES ARE Ø375 RCP CLASS '3' U.N.O.

**AS CONSTRUCTED**

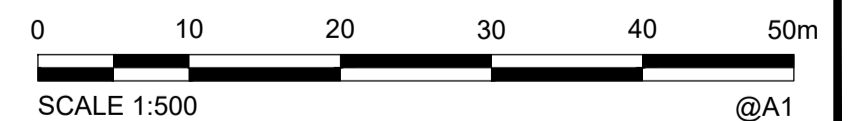

**COORDINATE DATUM NOTE:**  
 HORIZONTAL COORDINATES (E,N) SUPPLIED ARE MAPPING GRID OF AUSTRALIA (MGA), ZONE 56 BASED ON THE UNIVERSAL TRANSVERSE MERCATOR PROJECTION AND THE GEOCENTRIC DATUM OF AUSTRALIA 2020.

<b>A1</b>																<b>IPSWICH CITY COUNCIL</b> AURORA STAGE 7 AS-CONSTRUCTED STORMWATER 1546/2020/PDA			SCALE 1500 @A1 SHEET 1 OF 1 SHEETS DRAWING NO. BRSS5365-007-85-1		
				DRAWN MK 1/04/2025			CHECKED RA 1/04/2025			PASSED RA 1/04/2025											
	INDEX			DATE			INITIALS			DATE											
	1			1/04/2025			INITIAL ISSUE			MK RA RA											