
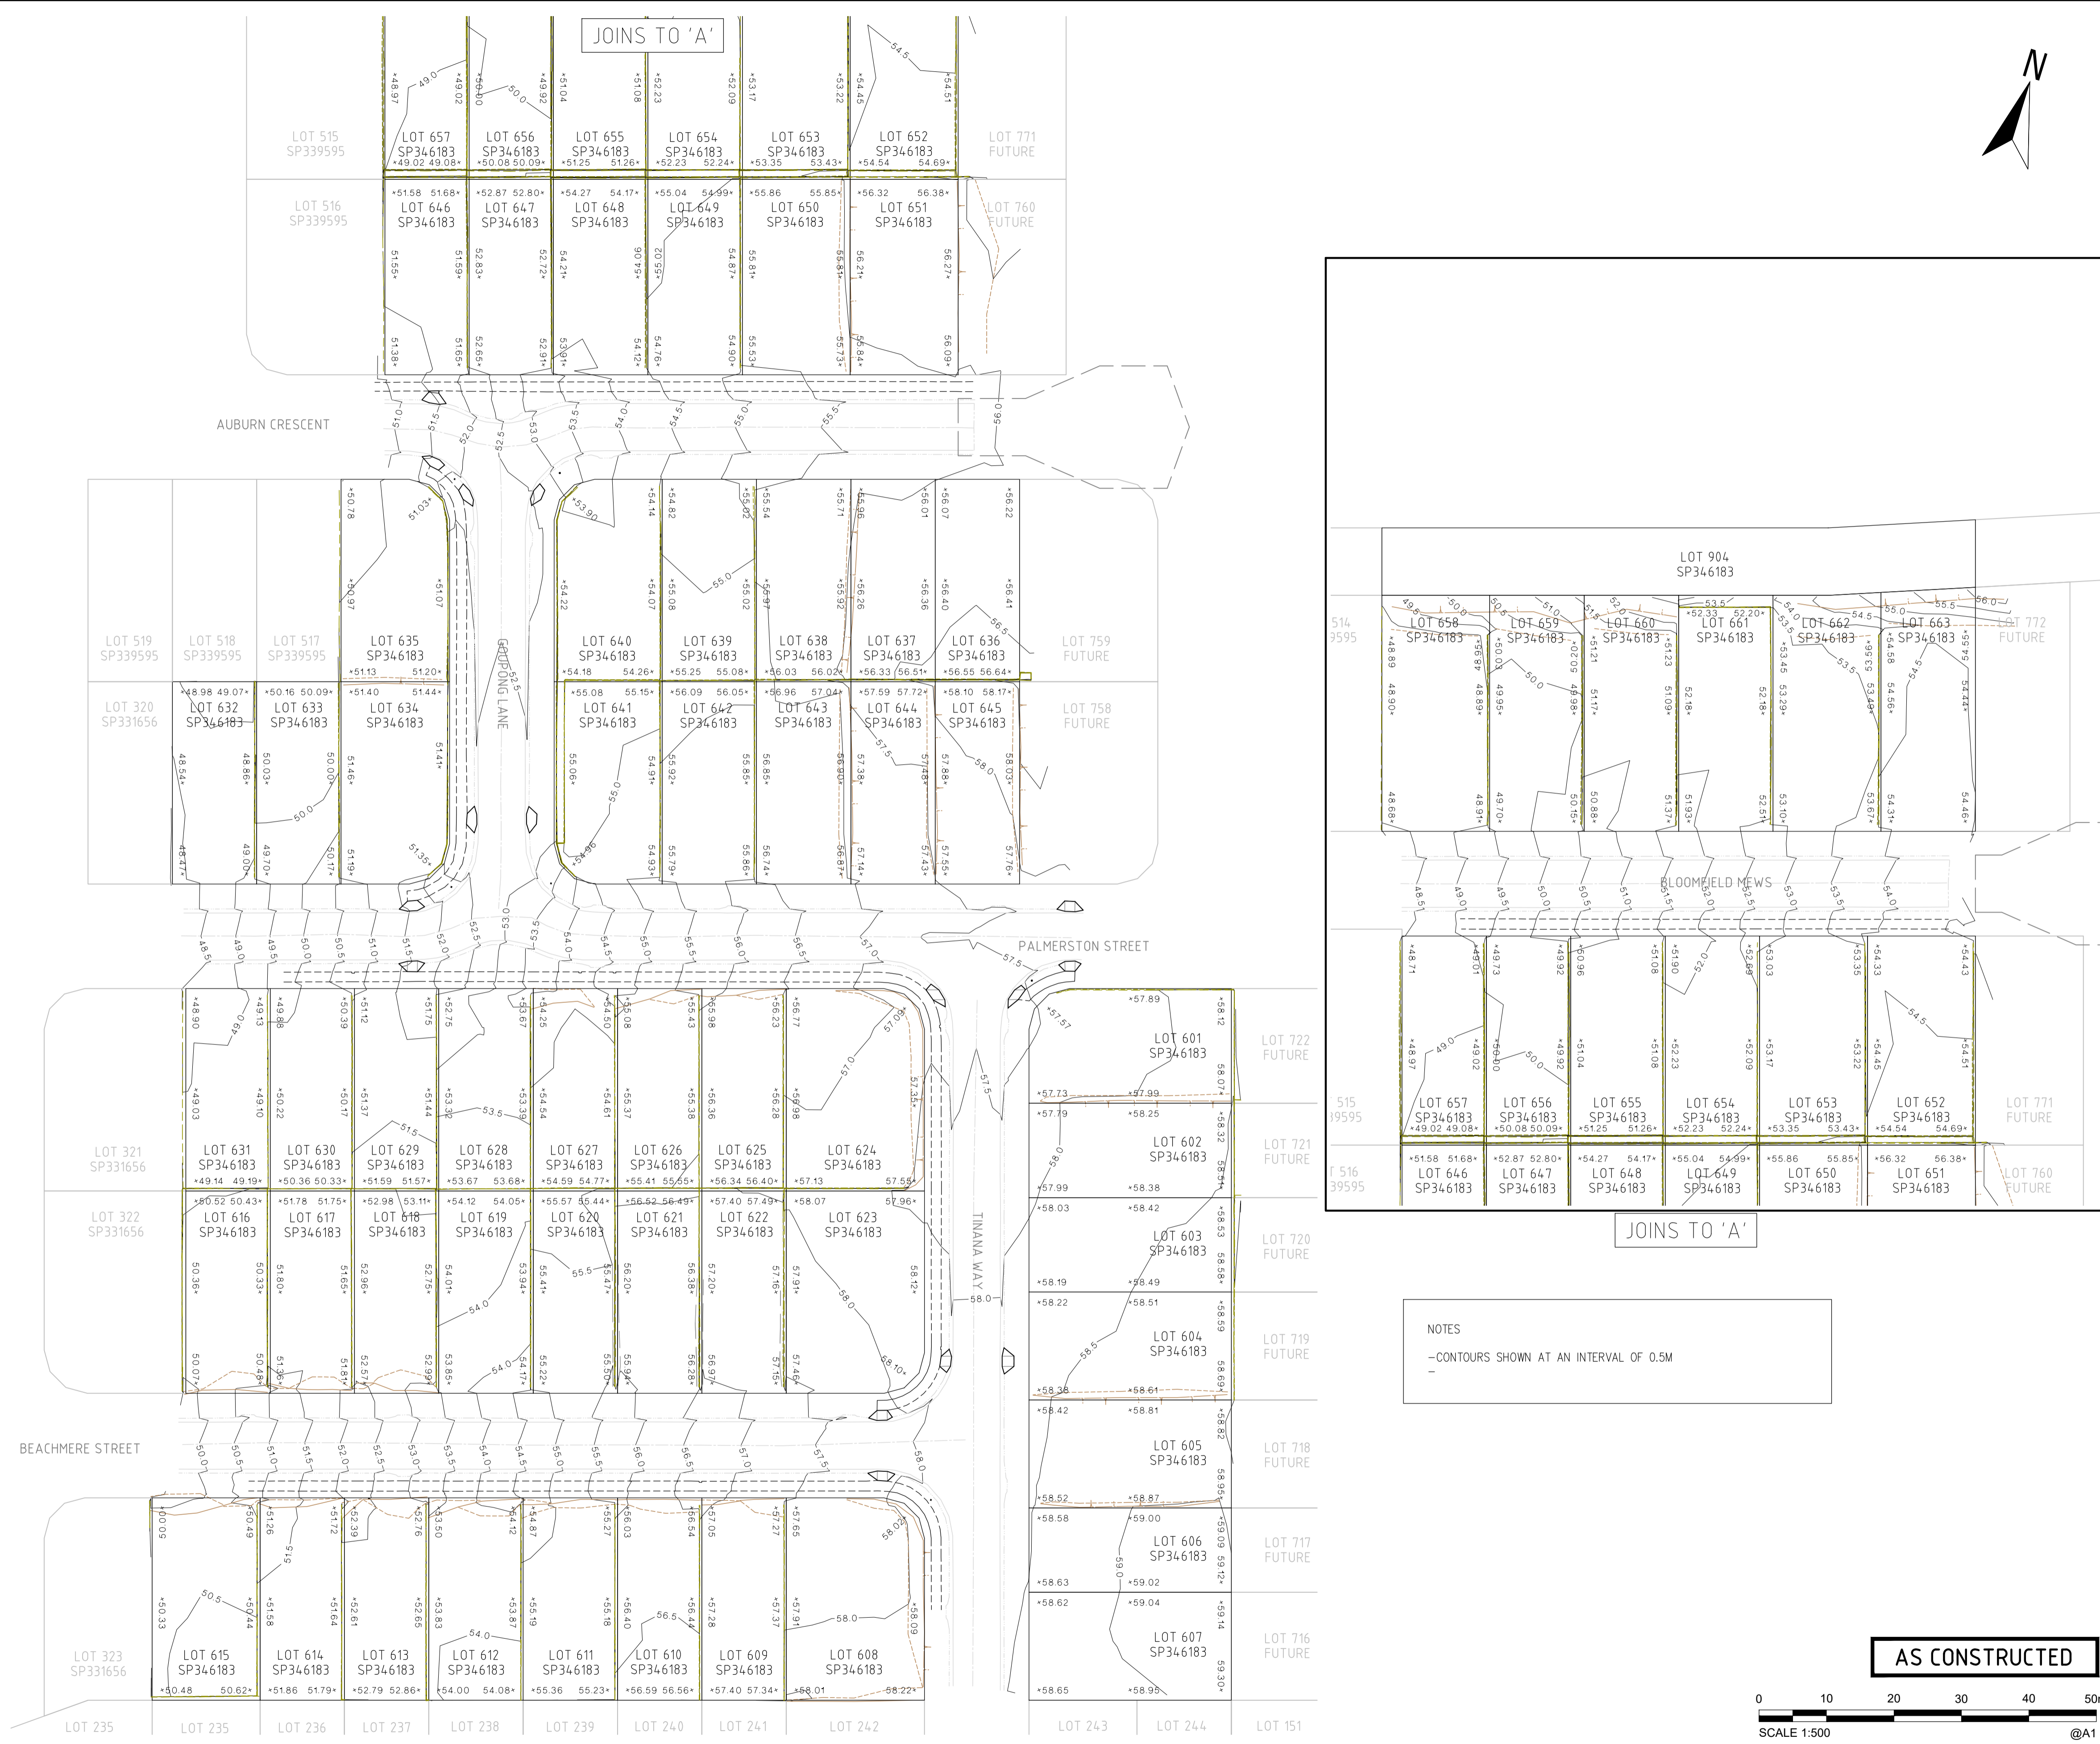


LEGEND

	BOTTOM OF WALL
	TOP OF WALL
	LIP OF KERB
	BACK OF KERB
	EDGE OF CONCRETE
	CONTOURS
	CHANGE OF GRADE
	BOTTOM OF BANK
	TOP OF BANK
	CROWN OF ROAD

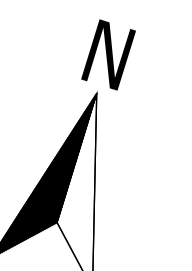


REGISTERED CADASTRAL SURVEYOR (QLD) CERTIFICATION
 LandPartners Pty Ltd, hereby certify that the horizontal and vertical locations, and dimensions shown on this plan are a true and correct record of the As Constructed information.
 4118
R. G. Anderson 1/04/2025
 Authorised Delegate Rego No. Date
 LandPartners Pty Ltd
 Registered Qld Surveyor Corporation

AS CONSTRUCTED CERTIFICATION
 I, _____ (Company's representative Name) _____ (Signature)
 _____ (Date) _____ (RPEQ)
 Being a duly representative of:- _____ (Company Name)
 Hereby certify that
 1. The information contained in this drawing / document is in compliance with approved drawings and design supplied under the Terms of the contract.
 2. This represents an accurate "As constructed" record of works carried out and accept responsibility for the information contained in this drawing / document.

COORDINATE DATUM NOTE:
 HORIZONTAL COORDINATES (E,N) SUPPLIED ARE MAPPING GRID OF AUSTRALIA (MGA), ZONE 56 BASED ON THE UNIVERSAL TRANSVERSE MERCATOR PROJECTION AND THE GEOCENTRIC DATUM OF AUSTRALIA 2020.

NOTES
 -CONTOURS SHOWN AT AN INTERVAL OF 0.5M

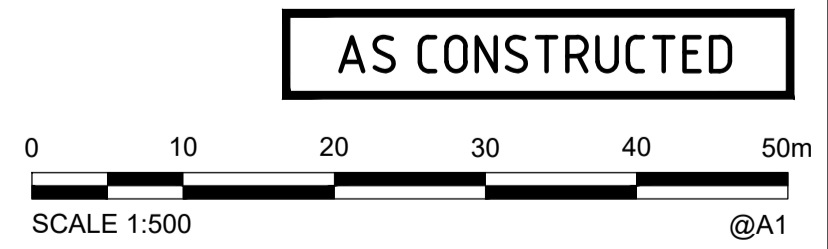


AS CONSTRUCTED

A1	1	1/04/2025	INITIAL ISSUE	MJK	RA	RA
	INDEX	DATE	REVISIONS	DRAWN	CHECKED	PASSED

DRAWN	MJK	1/04/2025
CHECKED	RA	1/04/2025
PASSED	RA	1/04/2025
INITIALS	DATE	

LANDPARTNERS
 surveyors and planners
 Brisbane Office
 Level 1
 18 Little Cobby Street
 Milton QLD 4064
 PO Box 1399
 Milton
 QLD 4064
 P (07) 3842 1000
 F (07) 3842 1001
 E info@landpartners.com.au
 W www.landpartners.com.au

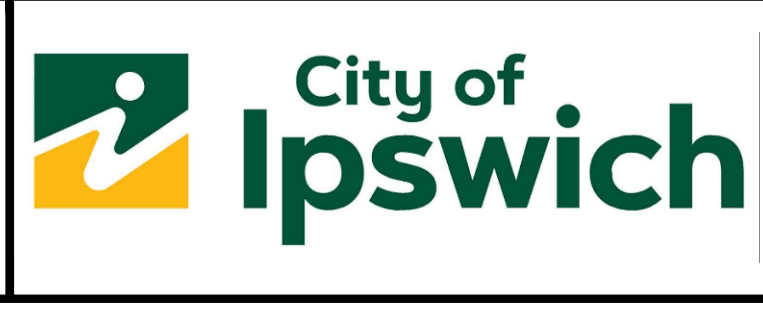

IPSWICH CITY COUNCIL
 AURORA STAGE 7
 AS-CONSTRUCTED TOPOGRAPHY
 1546/2020/PDA

SCALE 1500 @ A1
 SHEET 1 OF 1 SHEETS
 DRAWING NO.
 BRSS5365-007-86-1